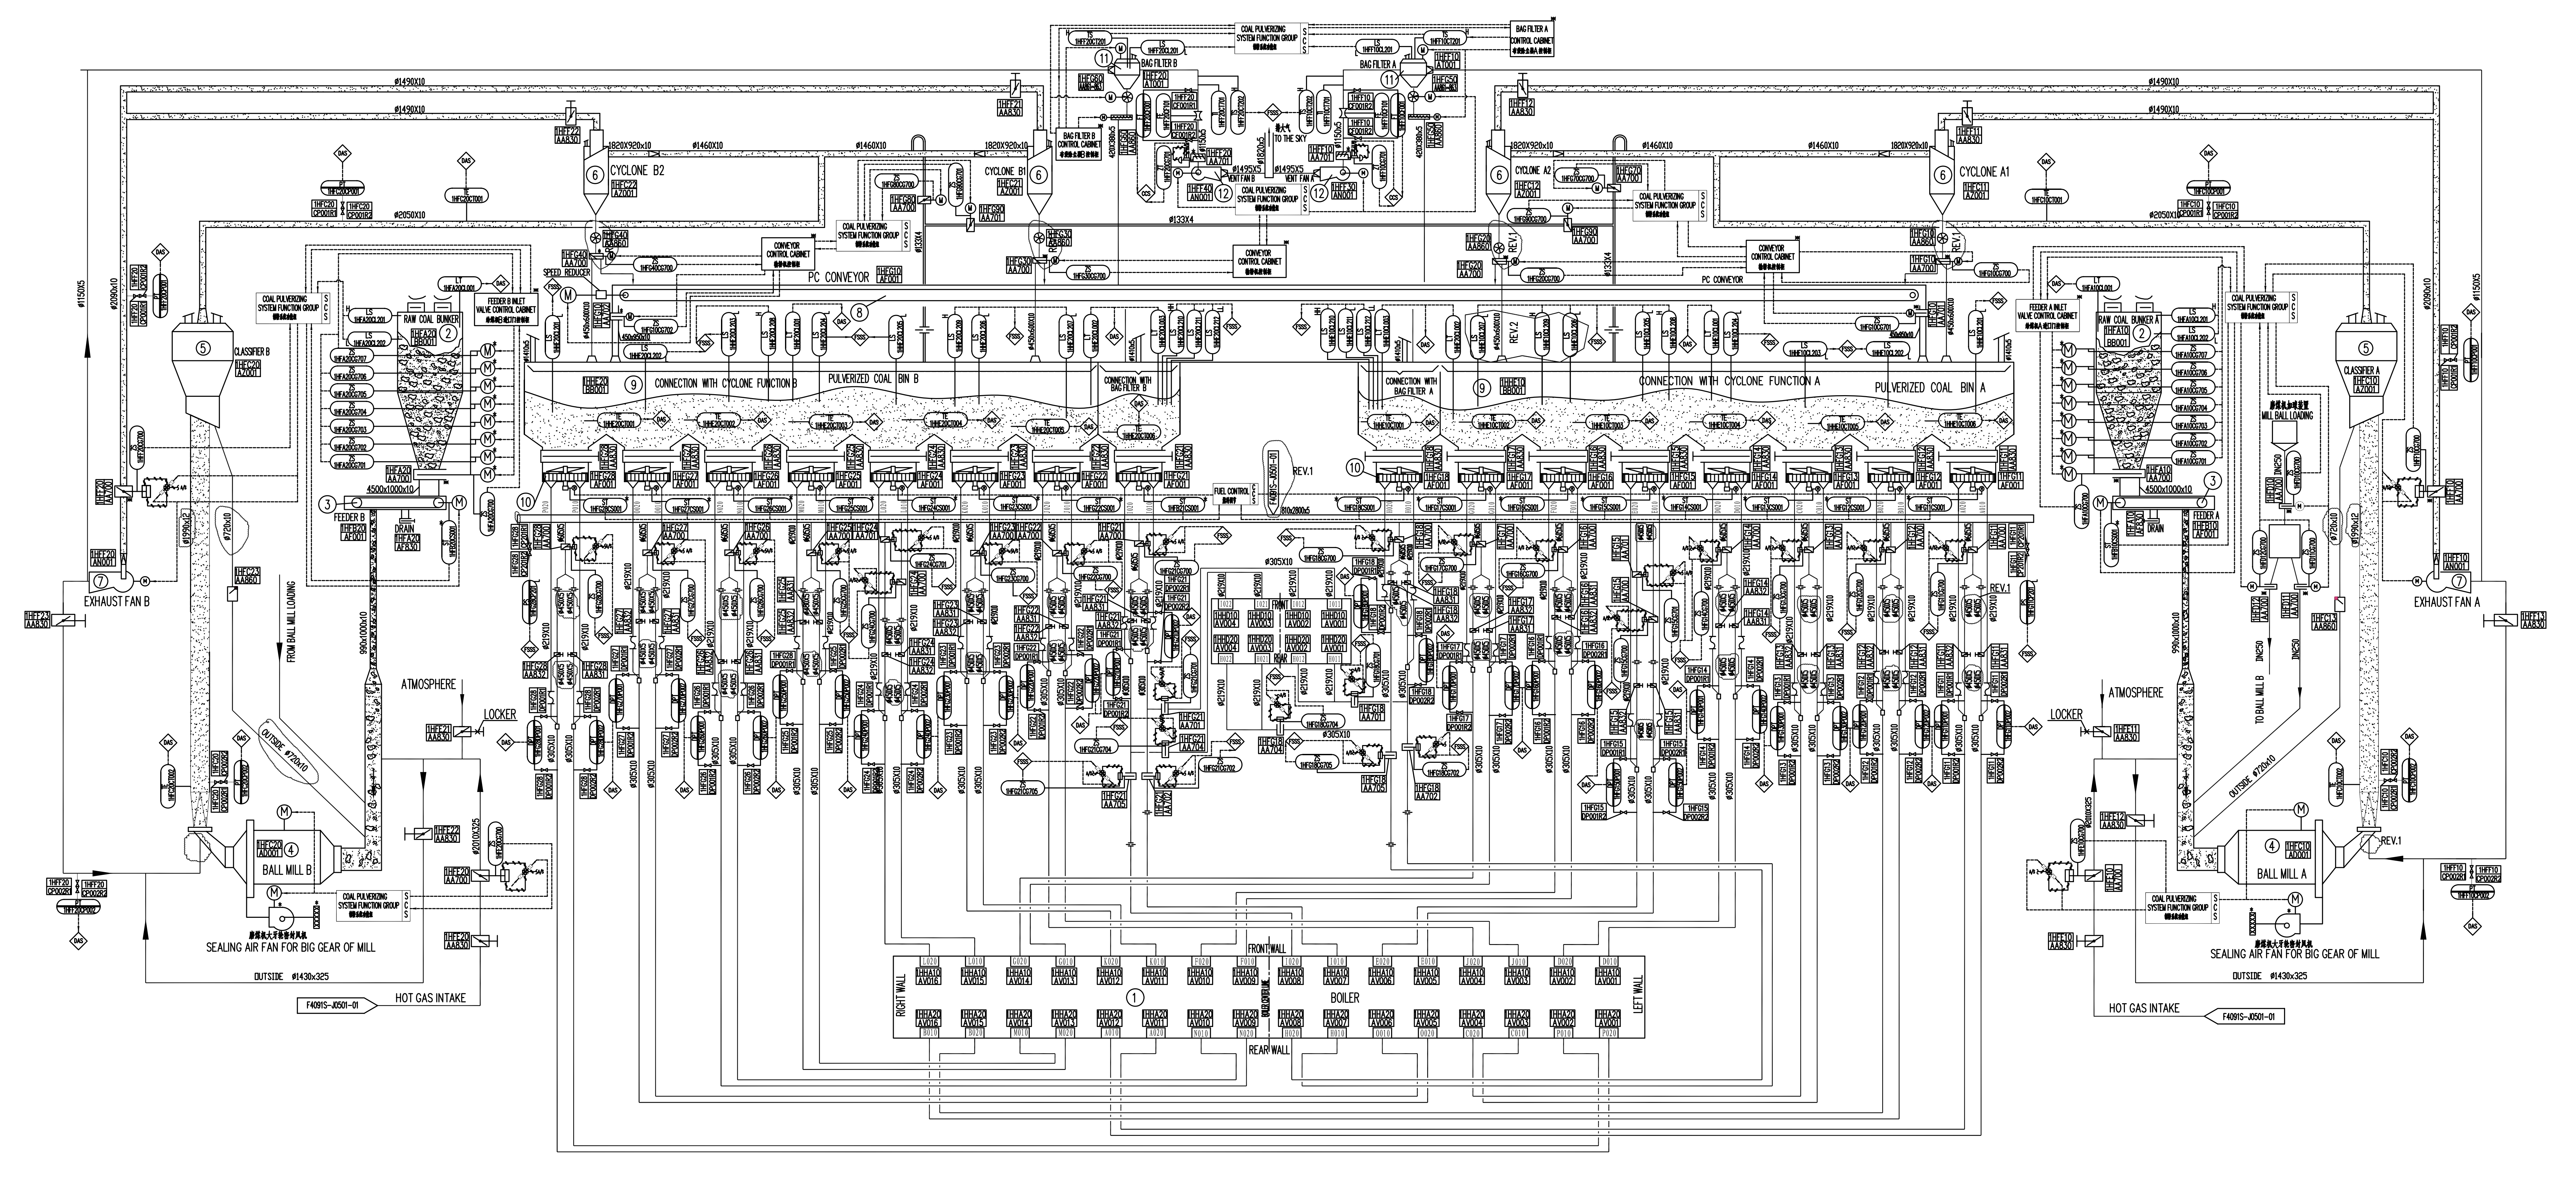

ABBREVIATION	DESCRIPTION
DAS	数据采集系统 DATA ACQUISITION SYSTEM
CCS	闭环控制系统 CLOSED CIRUIT CONTROL SYSTEM
SCS	顺序控制系统 SEQUENCE CONTROL SYSTEM
FSSS	炉膛安全监视系统 FURANCE SAFE SUPERVISION SYSTEM
DPS	差压开关 DIFFERENTIAL PRESSURE SWITCH
DPT	差压变送器 DIFFERENTIAL PRESSURE TRANSMITTER
FT	流量变送器 FLOW TRANSMITTER
FE	流量元件 FLOW ELEMENT
PS	压力开关 PRESS SWITCH
PT	压力变送器 PRESS TRANSMITTER
TE	温度元件 TEMPERATURE ELEMENT
TS	温度开关 TEMPERATURE SWITCH
LS	液位开关 LEVEL SWITCH
LT	液位变送器 LEVEL TRANSMITTER
	柜内安装仪表 INSTRUMENT INSTALLED IN CABINET
	就地仪表 LOCAL MEASURE INSTRUMENT

说明：

1. 所有变送器均为带就地指示的智能变送器.
2. 图中仪表阀的数量仅为示意，详细配置参见仪表阀门清册.
3. 图中标"＊"的仪表设备由厂家成套供货.
4. 参考图号：ALSTOM 0.05.008.00.52 F0011~F0013；
   ALSTOM 0.05.008.00.52 F0029；
   ALSTOM 0.05.008.00.52 B0700~B0703图.
5. 设备编号从固定端到扩建端依次排列A、B、C、D.
6. 本图编码为1号机组，2号机组编码仅将机组号编号"1"改为"2"即可.
7. 除特别说明外，设备明细表中数量按一台机组开列.
8. 从炉前往炉后看，本工程为右扩建.

NOTE:

1. SMART TRANSMITTERS EQUIPPED WITH LOCAL INDICATORS SHALL BE SUPPLIED FOR ALL TRANSMITTERS.
2. THE NUMBER OF THE VALVE FOR TRANSMITTERS AND INDICATORS SHOWED IN THIS DRAWING IS ONLY FOR REFERRENCE, PLEASE SEE THE CORRESPONDING PIPE AND VALVE SHEET OR VOLUMES OF I&C FOR DETAIL.
3. THE EQUIPMENTS MARKED WITH "*" ARE SUPPLIED BY THE MANUFACTURER.
4. REFERRENCE DRAWING NUMBER: ALSTOM 0.05.008.00.52 F0011~F0013;
   ALSTOM 0.05.008.00.52 F0029;
   ALSTOM 0.05.008.00.52 B0700~B0703.
5. THE EQUIPMENTS ARRANGED FROM THE FIXED END TO THE EXTEND END ARE CODED ALONG WITH LETTER A、B、C AND D.
6. THE KKS CODES OF EQUIPMENT ARE FOR UNIT NO.1 ,FOR UNIT NO.2 THE FIRST NUMBER OF THE CODES SHALL BE "2",THE OTHER NUMBER IS THE SAME WITH UNIT NO.1 .
7. THE EQUIPMENTS QUANTITIES ARE LISTED FOR ONE UNIT UNLESS OTHERWISE SPECIFIED.
8. IT IS RIGHT EXPANSION(VIEWED FROM TURBINE TO BOILER).

符 号 MARKS	名 称 NAME	符 号 MARKS	名 称 NAME
	气动插板式煤闸门 PNEUMATIC GATE DAMPER		原煤管道 COAL DUCT
	电动插板式煤闸门 MOTOR GATE DAMPER		吸潮管 WATER ABSORBER PIPE
	手动插板式煤闸门 MANUAL GATE DAMPER		风粉混合器 GAS PC MIXER
	气动简单百叶窗式挡板门 PNEUMATIC SIMPLE LOUVER DAMPER		送粉管道 COAL-AIR DUCT
	锁气器 CHECK DAMPER		煤粉管道 PULVERIZED DUCT
	手动关断门 MANUAL CLACK DAMPER		电动螺旋输粉机 MOTOR ENDLESS SCREW
	电动关断门 MOTOR CLACK DAMPER		防爆门 FLAME-PROOF DAMPER
	气动关断门 PNEUMATIC CLACK DAMPER		可调缩孔 THROTTLE REGULATOR
	电动调阀式锁气器 MOTOR BUCKET WHEEL		方圆节 REDUCER
	流量测量装置 FLOW NOZZLE		大小头 REDUCER
	电动自动调节门 AUTO ADJUSTED DAMPER		金属软管 FLEXIBLE HOSE

图 例 符 号 表
SYMBOL AND LEGEND

编号 NO.	名 称 NAME	型 号 及 规 范 TYPE & SPECIFICATION	数 量 QUANTITY	备 注 REMARK
12	电动机 MOTOR	型号 电压 功率 Type:YKK400-4 Voltage: 6.6kV Power:250 KW	2	SHENGYANG BLOWER FAN FACTORY LIMITED COMPANY
	排气风机 VENT FAN	型号(Type):SFY15F-C5A 全压(Total Pressure):5700Pa 风量(Flow Volume): 28.36 m³/S	2	
11	布袋除尘器 BAG FILTER	型号 Type:XLDM1600.WX	2	XINZHONG HUANBAO EQUIPMENT CO.LTD
10	电动机 MOTOR	型号 电压 功率 Type:YB132M1-6 Voltage: 400V Power:7.1 KW	16	SHENGYANG HUADIAN POWER STATION ENGINEERING CO.LTD
	给粉机 PULVERIZED COAL FEEDER	型号 出力 Type: SGF-10 OUTPUT:3~13 t/h	16	
9	煤粉仓 PULVERIZED COAL BIN	有效容积 EFFECTIVE CAPACITY:681 m³	2	
8	电动机 MOTOR	型号 功率 Type:D103-Y7.5-4P-20-W Power:7.5X2 KW	1	SHENYANG ELECTRIC POWER MACHINE FACTORY.
	螺旋输粉机 SPIRAL PULVERIZED COAL CONVEYOR	型号 出力 Type: LSG-500 OUTPUT:100t/h	1	
7	电动机 MOTOR	型号 电压 功率 Type:YKK560-6 Voltage: 6.6KV Power:710 KW	2	CHENGDU POWER MACHINERY WORKS
	排粉风机 EXHAUST FAN	型号(Type):MI25452 全压(Total Pressure):7800Pa 风量(Flow Volume): 24.03X10⁴ m³/h	2	
6	细粉分离器 CYCLON	型号 Type:2Xø3500	2	WUXI LIANYING ELECTRICAL EQUIPMENT LIMIED COMPANY
5	粗粉分离器 CLASSIFIER	型号 轴向 Type: ø6800 Axial	2	
4	电动机 MOTOR	型号 电压 功率 Type:YTM900-6 Voltage: 6.6KV Power:3500kW	2	SHANG HAI HEAVY MACHINE WORKS
	磨煤机 MILL	型号 出力 Type:BBI4796 OUTPUT:100t/h	2	
3	电动机 MOTOR	型号 功率 Type:Y160L-6 Power:11kW	2	HUBEI YIDU ELECTRICALY ENGINEERING STOCK LIMMIED COMPANY
	埋刮板给煤机 SCRAPE COAL FEEDER	型号 出力 Type:RMSD100 OUTPUT:30~110t/h	2	
2	原煤仓 RAW COAL BUNKER	有效容积 EFFECTIVE CAPACITY:1110 m³	2	
1	锅炉 BOILER	SG-995/17.3-M728	1	SHANG HAI BOILER WORKS

EQUIPMENT LIST 设备明细表

DOCUMENT STATUS AS BUILT

REV.	DATE	DRAWN	DESIGNED	CHECKED	REVIEWED		APPROVED	DESCRIPTION
2	2010.08		赵亚宁	潘浩	吴森		徐红	
1	2007.11	杨向利 王欢	张伏叶 薛娟	张伏叶 鲁齐	钟晓春	毕建惠	韩子俊	
0	2007.05	杨向利 王欢	张伏叶 薛娟	张伏叶 鲁齐	钟晓春	毕建惠	韩子俊	

OWNER	QUANG NINH THERMAL POWER JOINT STOCK COMPANY
CONTRACTOR	SHANGHAI ELECTRIC (GROUP) CORPORATION
SUBCONTRACTOR	NORTHWEST ELECTRIC POWER DESIGN INSTITUTE
CONTRACT NO.	32003/QNTPJSC-SEC
PROJECT CONTROL NO.	QN1-SEC-M-52-H-0401-01

竣工图
AS BUILT
西北电力设计院
Northwest Electric Power Design Institute

Nwepdi
西北电力设计院

COPYRIGHT (C)
USED FOR THE PROJECT ONLY.
NWEPDI RESERVE THE RIGHT OF
RECOURSE AGAINST INFRINGEMENT.

QUANG NINH THERMAL POWER PLANT PHASE 1: 2X300MW PROJECT
DESIGN STAGE DETAIL

锅炉制粉系统流程图
P & ID FOR BOILER COAL PULVERIZING SYSTEM

UNITS mm SCALE ~ DAWG. NO. F4091S-J0401-01 SHEET 1 OF 1 REV. 2