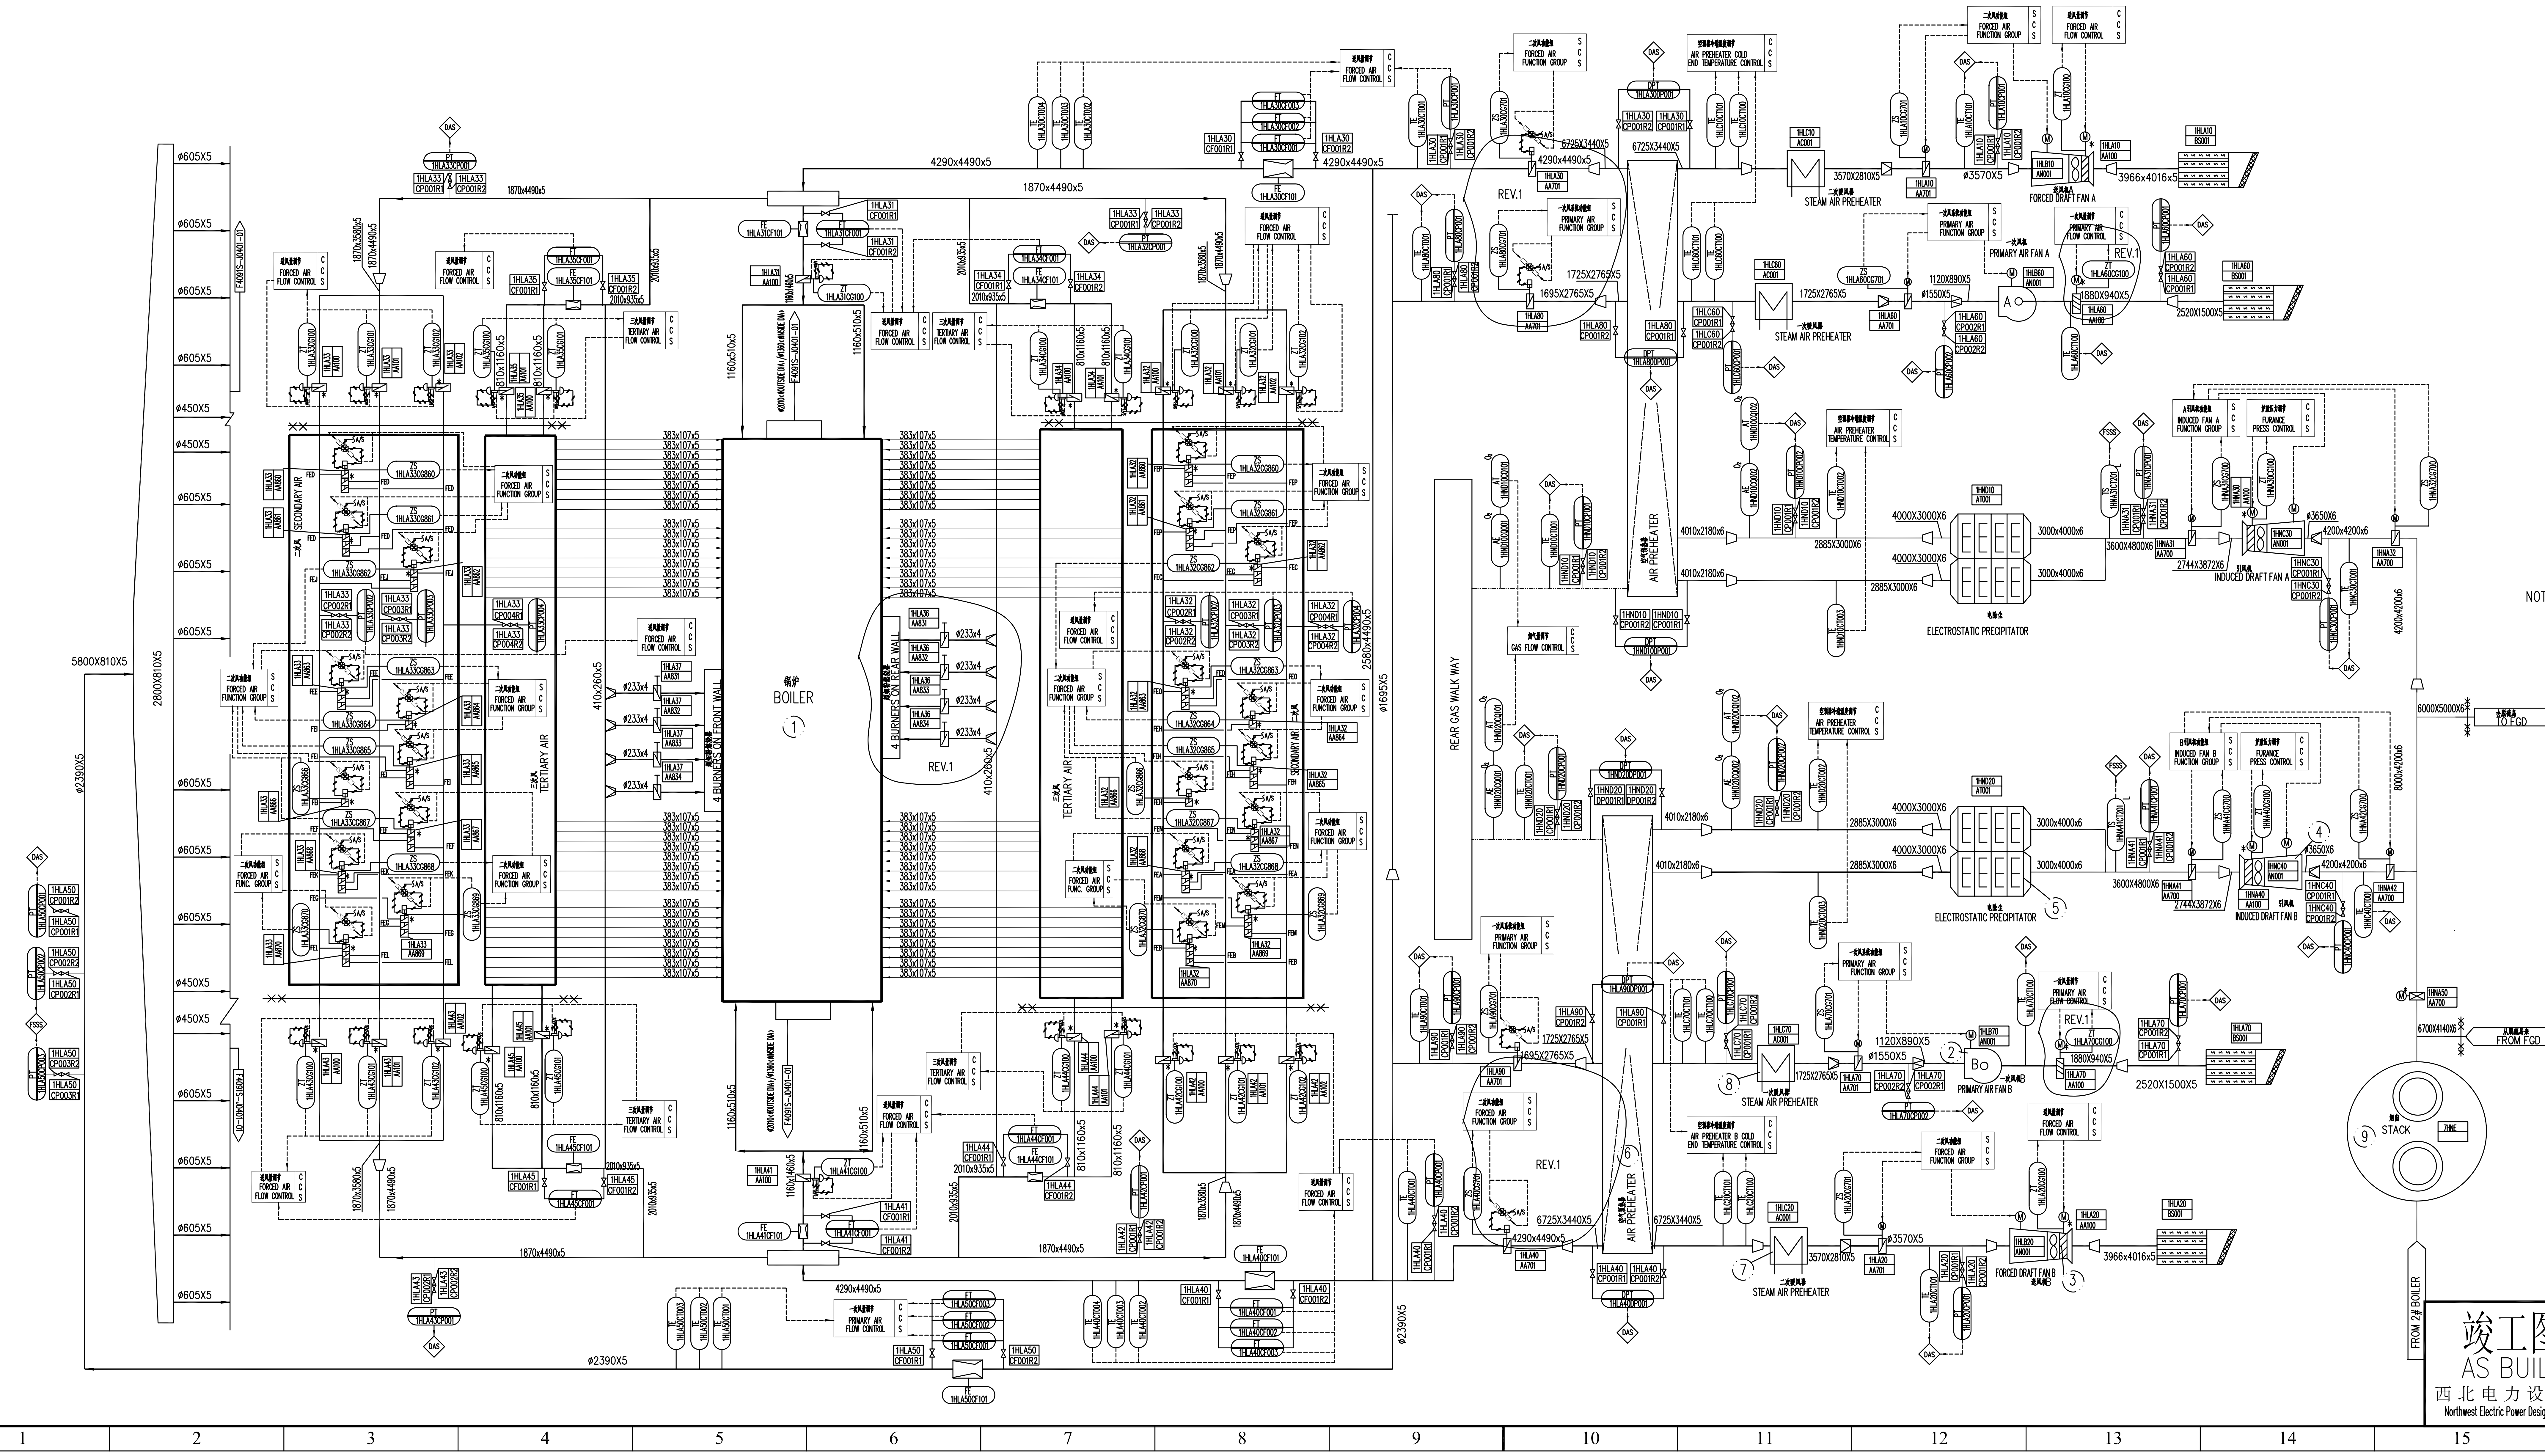

符 号 MARKS	名 称 NAME	符 号 MARKS	名 称 NAME
───	风道 AIR DUCT		气动风门 PNEUMATIC ON/OFF DAMPER
───	烟道 GAS DUCT	XXXX	滤网 AIR STRAINER
	电动风门 MOTOR ON/OFF DAMPER		消音器 SILENCER
	气动调节风门 CONTROL AUTOMATIC DAMPER		电动风门 MOTOR DAMPER
	导叶调节风门 CONTROL AUTOMATIC MULTIPLE LOUVER DAMPER		风量测量装置 VENTURY-TYPE AIR FLOW NOZZLE
	手动风门 MANUAL DAMPER		

图 形 符 号 表
SYMBOL AND LEGENDS

SYMBOL AND LEGENDS

DAS	数据采集系统 DATA ACQUISITION SYSTEM
CCS	闭环控制系统 CLOSED CIRUIT CONTROL SYSTEM
SCS	顺序控制系统 SEQUENCE CONTROL SYSTEM
FSSS	炉膛安全监视系统 FURANCE SAFE SUPERVISION SYSTEM
DPS	差压开关 DIFFERENTIAL PRESSURE SWITCH
DPT	差压变送器 DIFFERENTIAL PRESSURE TRANSMITTER
FS	流量开关 FLOW SWITCH
FT	流量变送器 FLOW TRANSMITTER
FE	流量元件 FLOW ELEMENT
PS	压力开关 PRESS SWITCH
PT	压力变送器 PRESS TRANSMITTER
TE	温度元件 TEMPERATURE ELEMENT
TS	温度开关 TEMPERATURE SWITCH
⊜	柜内安装仪表 INSTRUMENT INSTALLED IN CABINET
⬭	就地仪表 LOCAL MEASURE INSTRUMENT

NOTE: 1.SMART TRANSMITTERS EQUIPPED WITH LOCAL INDICATORS SHALL BE SUPPLIED FOR ALL TRANSMITTERS.
2.THE NUMBER OF THE VALVE FOR TRANSMITTERS AND INDICATORS SHOWED IN THIS DRAWING IS ONLY FOR REFERRENCE, PLEASE SEE THE CORRESPONDING PIPE AND VALVE SHEET OR VOLUMES OF I&C FOR DETAIL.
3.THE EQUIPMENTS MARKED WITH "*" ARE SUPPLIED BY THE MANUFACTURER.
4.REFERRENCE DRAWING NUMBER: ALSTOM 0.05.008.00.52 F0010~F0013.
5.GENERAL FOR ALL DUCTS NO. PID ALSTOM 0.05.008.00.52 F0007-B ,F0008-B,F0009-B, F0010-A,F0012-B,F0013-B,F0029-B.

NO.	NAME	TYPE & SPECIFICATION	QUANTITY	REMARK
9	烟囱 STACK	ø4600 H=200m	1	
8	二次暖风器 PRIMARY STEAM AIR PREHEATER	STEAM COIL HEATING STEAM:P=0.8MPa 350°C	2	HANKOU POWER EQUIPMENT WORKS
7	一次暖风器 FORCED STEAM AIR PREHEATER	STEAM COIL HEATING STEAM:P=0.8MPa 350°C	2	
6	空气预热器 AIR PREHEATER	三分仓回转式 LUNGSTROM ROTORY TRISECTOR REGENERATIVE TYPE	2	SHANGHAI BOILER LIMED COMPANY
5	电除尘 ELECTROSTATIC PRECIPITATOR	双室四电场 DOUBLE CHAMBER FOUR FIELD TYPE >88.23%	2	
4	电动机 MOTOR	YKK710-8 6.6KV 1500kW	2	SHANGHAI POWER MACHINERY WORK
	引风机 INDUCED DRAFT FAN	281.35m^3/s 4053Pa	2	
3	电动机 MOTOR	YKK560-4 6.6KV 1250kW	2	SHANGHAI POWER MACHINERY WORK
	送风机 FORCED AIR FAN	177.6m^3/s 5267Pa	2	
2	电动机 MOTOR	YKK400-4 6.6KV 400kW	2	SHANGHAI POWER MACHINERY WORK
	一次风机 PRIMARY AIR FAN	33.99m^3/s 8480Pa	2	
1	锅炉 BOILER	SG-995/17.3-MXX	1	SHANGHAI BOILER LIMED COMPANY

EQUIPMENT LIST

DOCUMENT STATUS: AS BUILT

版本	日 期	制 图	设 计	校 核	审 核	审 核	批 准	备 注
1	2010.08		赵亚宁	潘浩	吴森		徐弘	
0	2007.05	袁桂伏 王欢	张伏叶 薛嫣	张伏叶 鲁齐	钟晓春	毕建惠	韩子俊	

OWNER	QUANG NINH THERMAL POWER JOINT STOCK COMPANY
CONTRACTOR	上海电气 SHANGHAI ELECTRIC (GROUP) CORPORATION
SUBCONTRACTOR	NORTHWEST ELECTRIC POWER DESIGN INSTITUTE
CONTRACT NO.	32003/QNTPJSC-SEC
PROJECT CONTROL NO.	QN1-SEC-M-52-H-0501-01

竣工图
AS BUILT
西北电力设计院
Northwest Electric Power Design Institute

Nwepdi
西北电力设计院

版权所有(C) 仅限本项目使用
西北电力设计院对侵权者保留追索权

QUANG NINH THERMAL POWER PLANT PHASE 1: 2X300MW 工程 | DETAIL 设计阶段

锅炉烟风系统流程图
PID DIAGRAM FOR BOILER AIR AND GAS SYSTEM

单位 mm | 比例 ~ | 图号 F4091S-J0501-01 | 第1张 共1张 | 版本 1