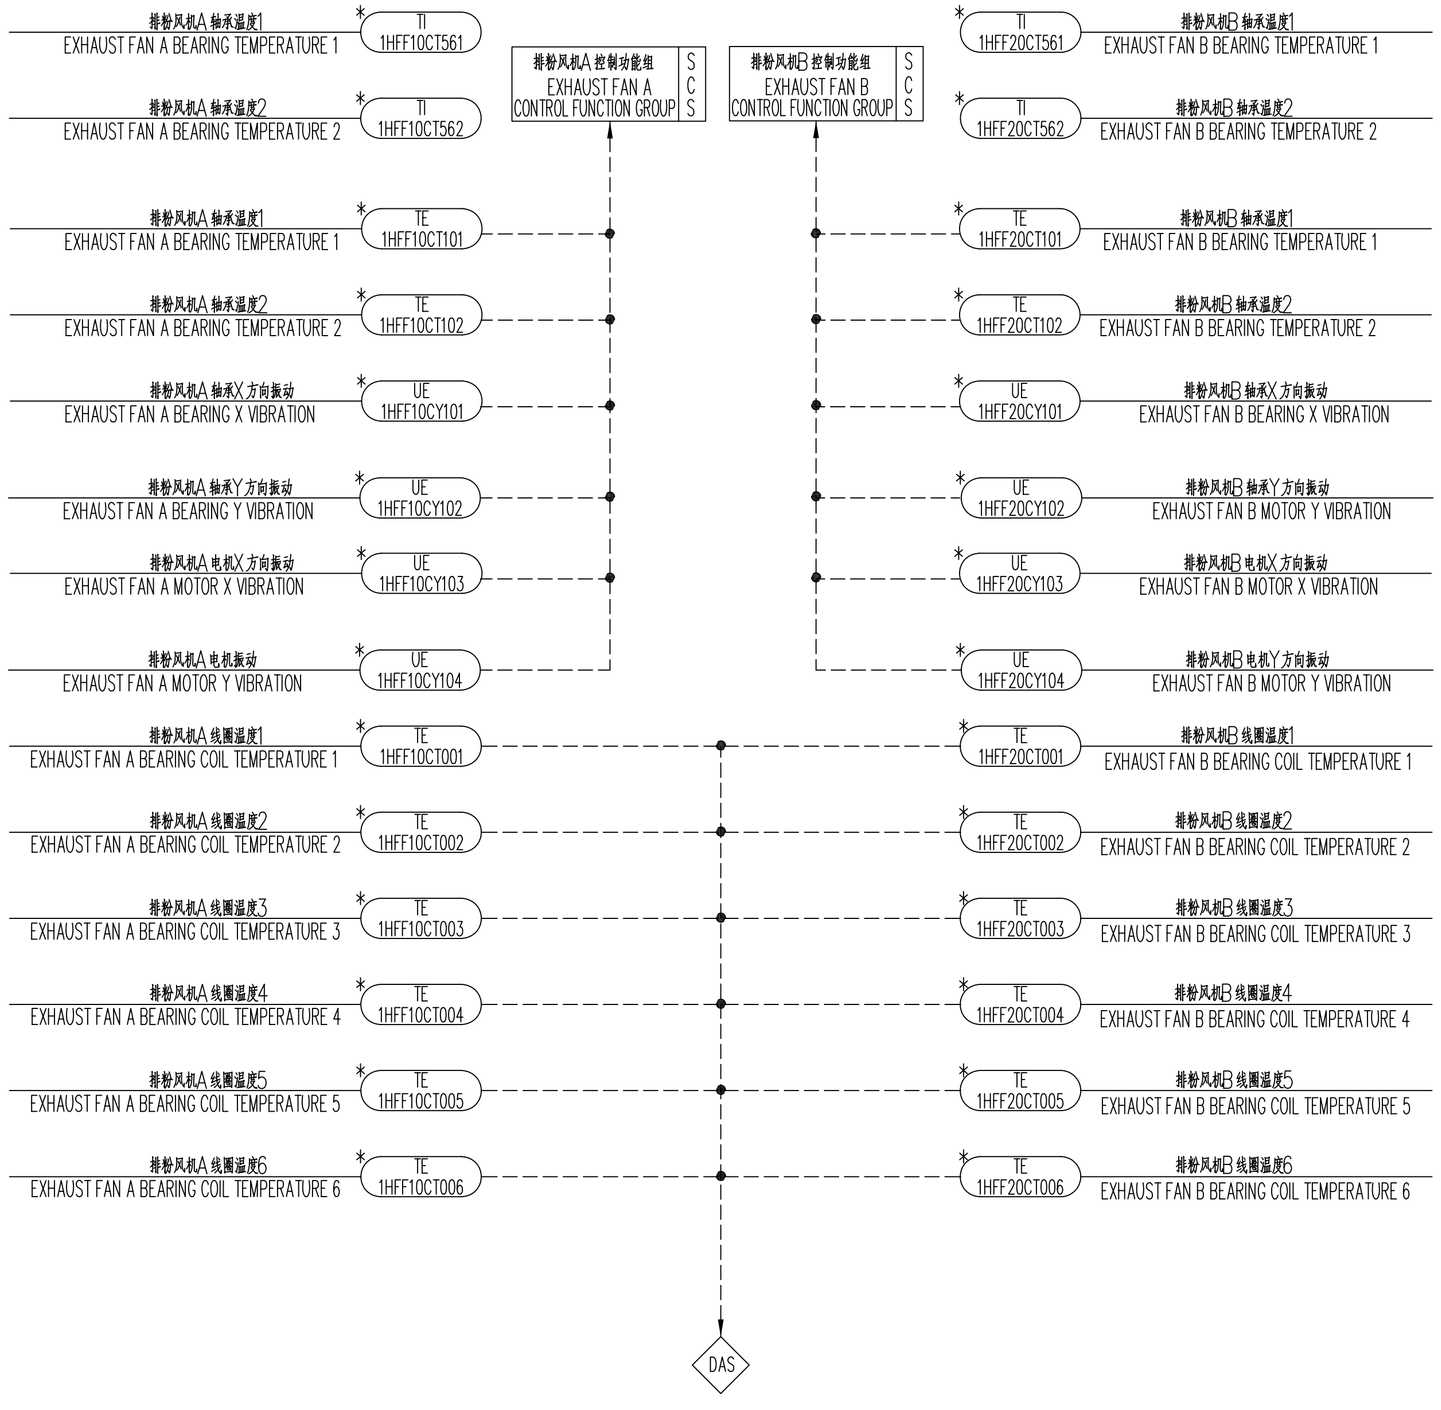


1. 图中标"*"的仪表设备由厂家成套供货。
2. 所有变送器均为带就地指示的智能变送器。
3. 本图编码为1号机组，2号机组编码仅将机组号编号"1"改为"2"即可。

1. THE EQUIPMENTS MARKED WITH "*" ARE SUPPLIED BY THE MANUFACTURER.
2. SMART TRANSMITTERS EQUIPPED WITH LOCAL INDICATORS SHALL BE SUPPLIED FOR ALL TRANSMITTERS.
3. THE KKS CODES OF EQUIPMENT ARE FOR UNIT NO.1 ,FOR UNIT NO.2 THE FIRST NUMBER OF THE CODES SHALL BE "2",THE OTHER NUMBER IS THE SAME WITH UNIT NO.1 .

竣工图
AS BUILT
西北电力设计院
Northwest Electric Power Design Institute

ENGIN. DESIGN CERTIFICATE GRADE A No. 260001-sj

DOCUMENT STATUS: AS BUILT

REV.	DATE	DRAWN	DESIGNED	CHECKED	REVIEWED	APPROVED	DESCRIPTION
0	2010.08						

OWNER	QUANG NINH THERMAL POWER JOINT STOCK COMPANY
CONTRACTOR	SHANGHAI ELECTRIC (GROUP) CORPORATION
SUBCONTRACTOR	NORTHWEST ELECTRIC POWER DESIGN INSTITUTE
CONTRACT NO.	32003/QNTPJSC-SEC
PROJECT CONTROL NO.	QN1-SEC-I-52-HFF-0103-08

Nwepdi 西北电力设计院

COPYRIGHT (C)
USED FOR THE PROJECT ONLY.
NWEPDI RESERVE THE RIGHT OF RECOURSE AGAINST INFRINGEMENT.

QUANG NINH THERMAL POWER PLANT PHASE 1: 2X300MW PROJECT | DETAIL DESIGN STAGE

P&ID FOR EXHAUST FAN A
排粉风机A 本体仪表控制系统图

UNITS	SCALE	DAWG. NO.	SHEET	REV.
mm	1:1	F4091S-K0103-08	1 OF 1	0