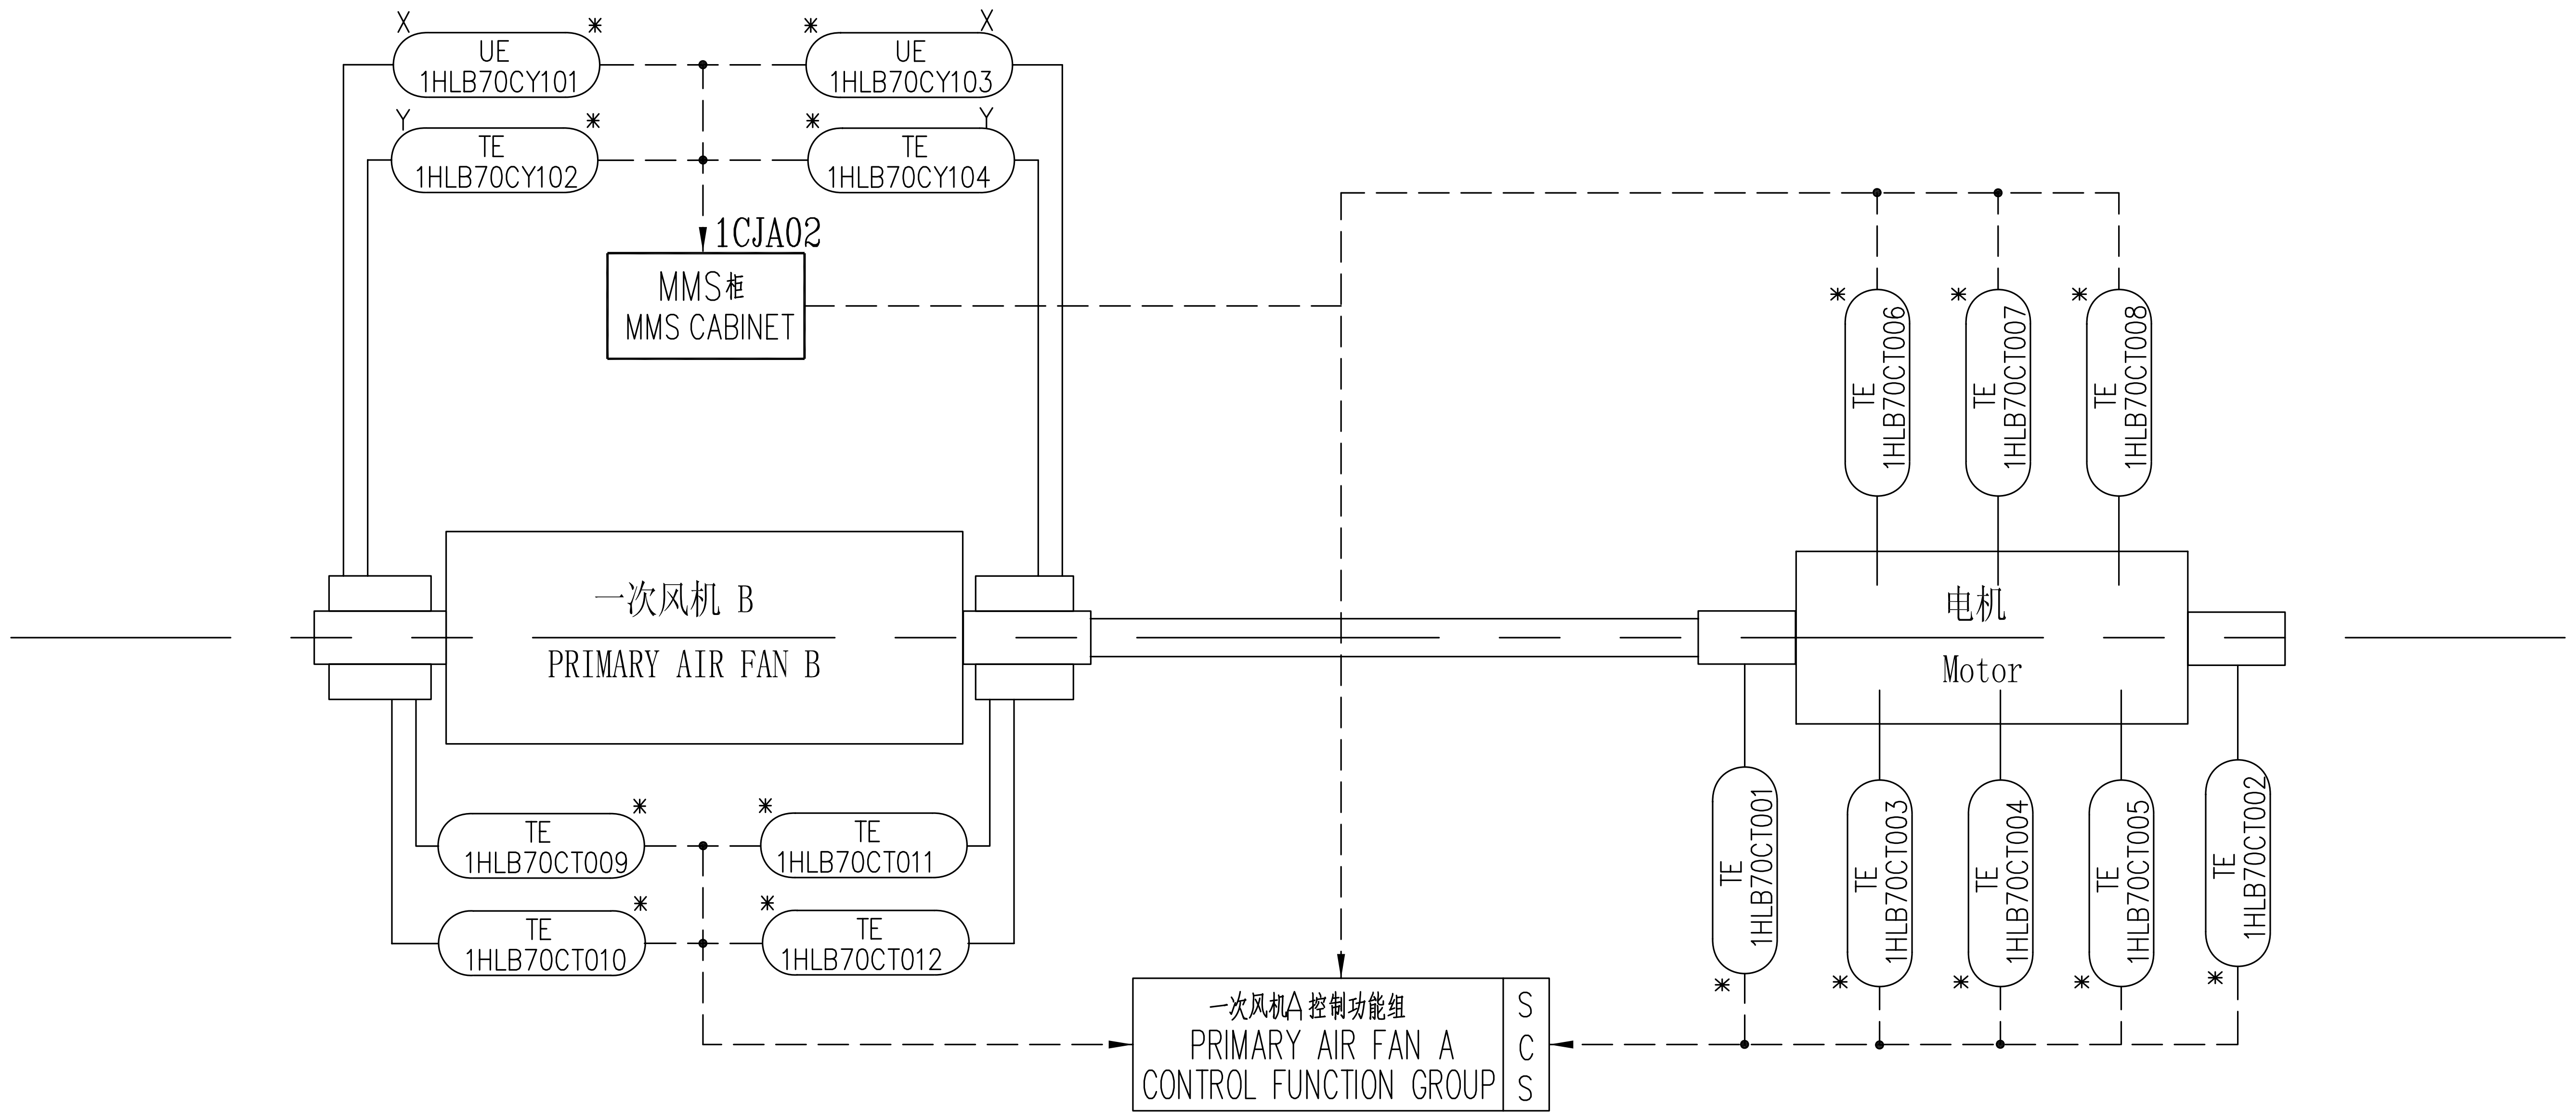

1. 所有变送器均为带就地指示的智能变送器。
2. 图中仪表阀的数量仅为示意，详细配置参见仪表阀门清册。
3. 图中标“＊”的仪表设备由厂家成套供货。
4. 参考图号：上海鼓风机厂有限公司2007.01《引风机P&I图》

1. SMART TRANSMITTERS EQUIPPED WITH LOCAL INDICATORS SHALL BE SUPPLIED FOR ALL TRANSMITTERS.
2. THE NUMBER OF THE VALVE FOR TRANSMITTERS AND INDICATORS SHOWED IN THIS DRAWING IS ONLY FOR REFERRENCE, PLEASE SEE THE CORRESPONDING PIPE AND VALVE SHEET OR VOLUMES OF I&C FOR DETAIL.
3. THE EQUIPMENTS MARKED WITH "*" ARE SUPPLIED BY THE MANUFACTURER.
4. REFERENCE DRAWING NO.: SHANGHAI FAN LTC.CO。2007.01《ID FAN P&I DIAGRAM》.

竣工图
AS BUILT
西北电力设计院
Northwest Electric Power Design Institute

DOCUMENT STATUS	AS BUILT

REV.	DATE	DRAWN	DESIGNED	CHECKED	REVIEWED	APPROVED	DESCRIPTION
0	2010.08				徐永成		

OWNER	QUANG NINH THERMAL POWER JOINT STOCK COMPANY
CONTRACTOR	SHANGHAI ELECTRIC (GROUP) CORPORATION
SUBCONTRACTOR	NORTHWEST ELECTRIC POWER DESIGN INSTITUTE
CONTRACT NO.	32003/QNTPJSC-SEC
PROJECT CONTROL NO.	QN1-SEC-I-63-HLB-0103-14

Nwepdi
西北电力设计院

COPYRIGHT (C)
USED FOR THE PROJECT ONLY.
NWEPDI RESERVE THE RIGHT OF
RECOURSE AGAINST INFRINGEMENT.

QUANG NINH THERMAL POWER PLANT PHASE 1: 2X300MW PROJECT

DETAIL DESIGN STAGE

P&ID FOR PRIMARY AIR FAN B
一次风机B本体仪表控制系统图

UNITS	mm	SCALE	1:1	DAWG. NO.	F4091S-K0103-14	SHEET 1 OF 1	REV.

ENGIN. DESIGN CERTIFICATE GRADE A No. 260001-sj