ENGIN. DESIGN CERTIFICATE GRADE A No. 260001-sj

竣工图
AS BUILT
西北电力设计院
Northwest Electric Power Design Institute

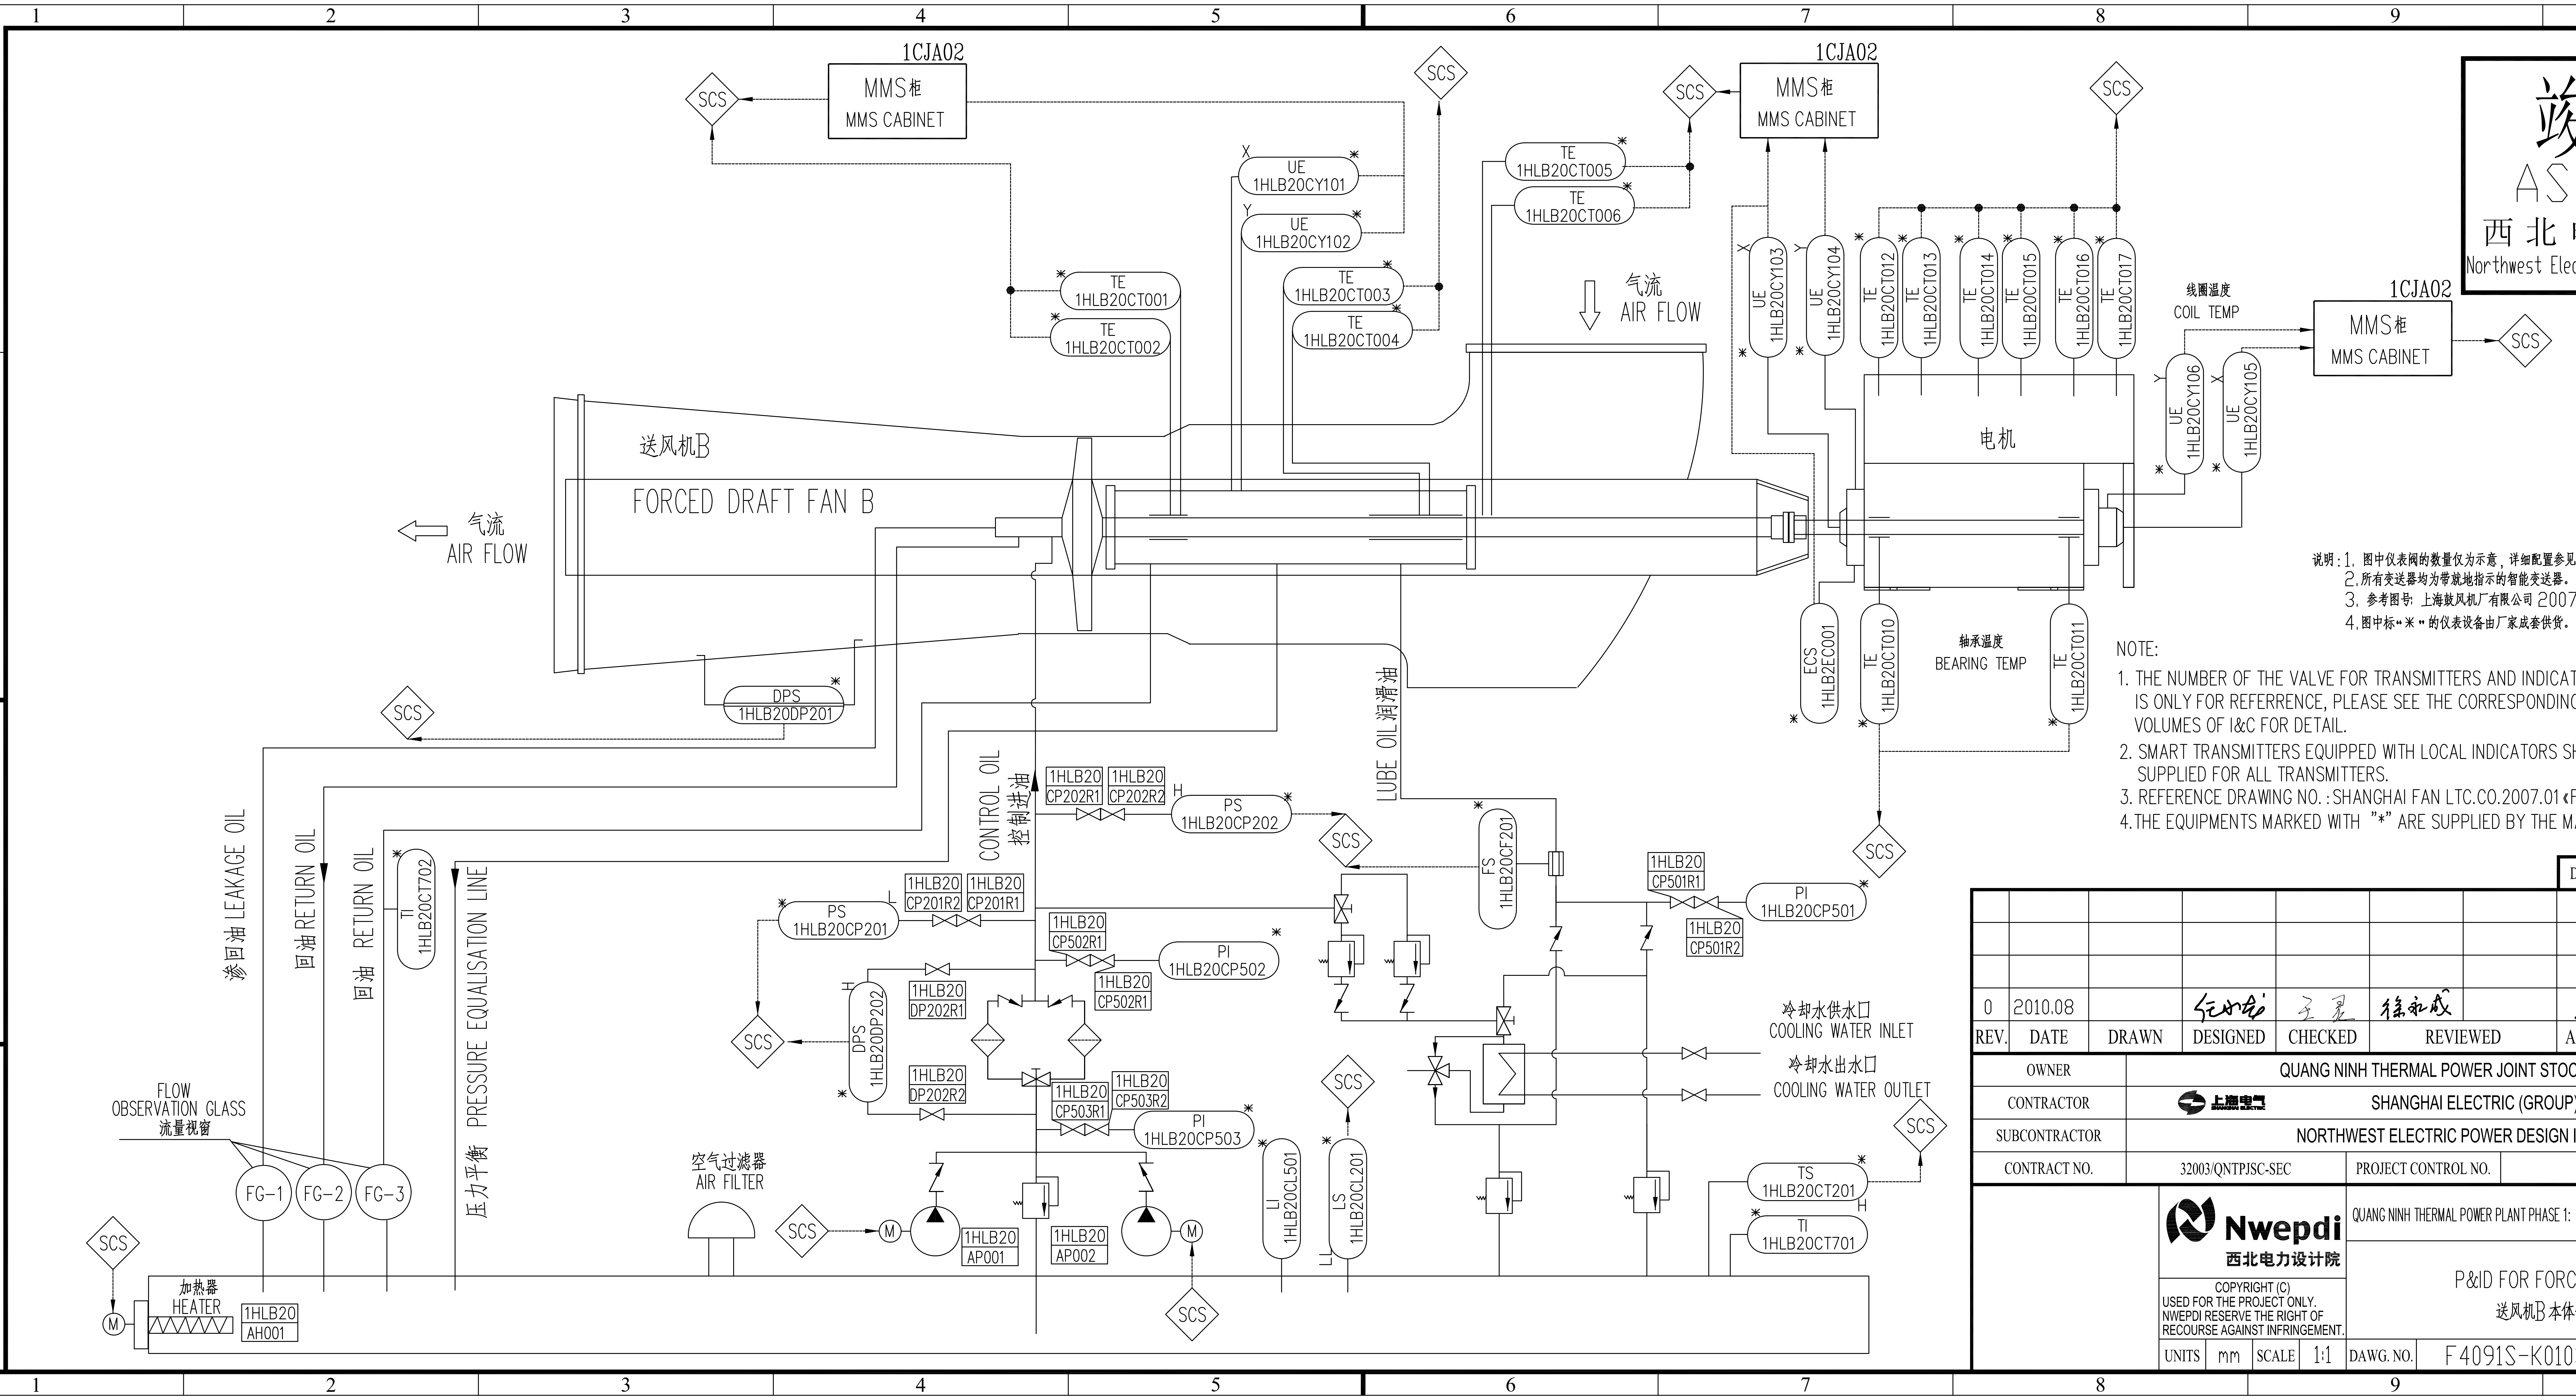

说明：1. 图中仪表阀的数量仅为示意，详细配置参见仪表阀门清册。
2. 所有变送器均为带就地指示的智能变送器。
3. 参考图号：上海鼓风机厂有限公司 2007.01《送风机P&I图》
4. 图中标“＊”的仪表设备由厂家成套供货。

NOTE:

1. THE NUMBER OF THE VALVE FOR TRANSMITTERS AND INDICATORS SHOWED IN THIS DRAWING IS ONLY FOR REFERRENCE, PLEASE SEE THE CORRESPONDING PIPE AND VALVE SHEET OR VOLUMES OF I&C FOR DETAIL.
2. SMART TRANSMITTERS EQUIPPED WITH LOCAL INDICATORS SHALL BE SUPPLIED FOR ALL TRANSMITTERS.
3. REFERENCE DRAWING NO.: SHANGHAI FAN LTC.CO.2007.01《FD FAN P&I DIAGRAM》.
4. THE EQUIPMENTS MARKED WITH "*" ARE SUPPLIED BY THE MANUFACTURER.

DOCUMENT STATUS	AS BUILT

REV.	DATE	DRAWN	DESIGNED	CHECKED	REVIEWED	APPROVED	DESCRIPTION
0	2010.08				徐永成		

OWNER	QUANG NINH THERMAL POWER JOINT STOCK COMPANY		
CONTRACTOR	上海电气 SHANGHAI ELECTRIC (GROUP) CORPORATION		
SUBCONTRACTOR	NORTHWEST ELECTRIC POWER DESIGN INSTITUTE		
CONTRACT NO.	32003/QNTPJSC-SEC	PROJECT CONTROL NO.	QN1-SEC-I-52-HLB-0103-16

Nwepdi
西北电力设计院

COPYRIGHT (C)
USED FOR THE PROJECT ONLY.
NWEPDI RESERVE THE RIGHT OF
RECOURSE AGAINST INFRINGEMENT.

QUANG NINH THERMAL POWER PLANT PHASE 1: 2X300MW PROJECT | DETAIL | DESIGN STAGE

P&ID FOR FORCED DRAFT FAN B
送风机B本体仪表控制系统图

UNITS	mm	SCALE	1:1	DAWG. NO.	F4091S-K0103-16	SHEET 1 OF 1	REV.