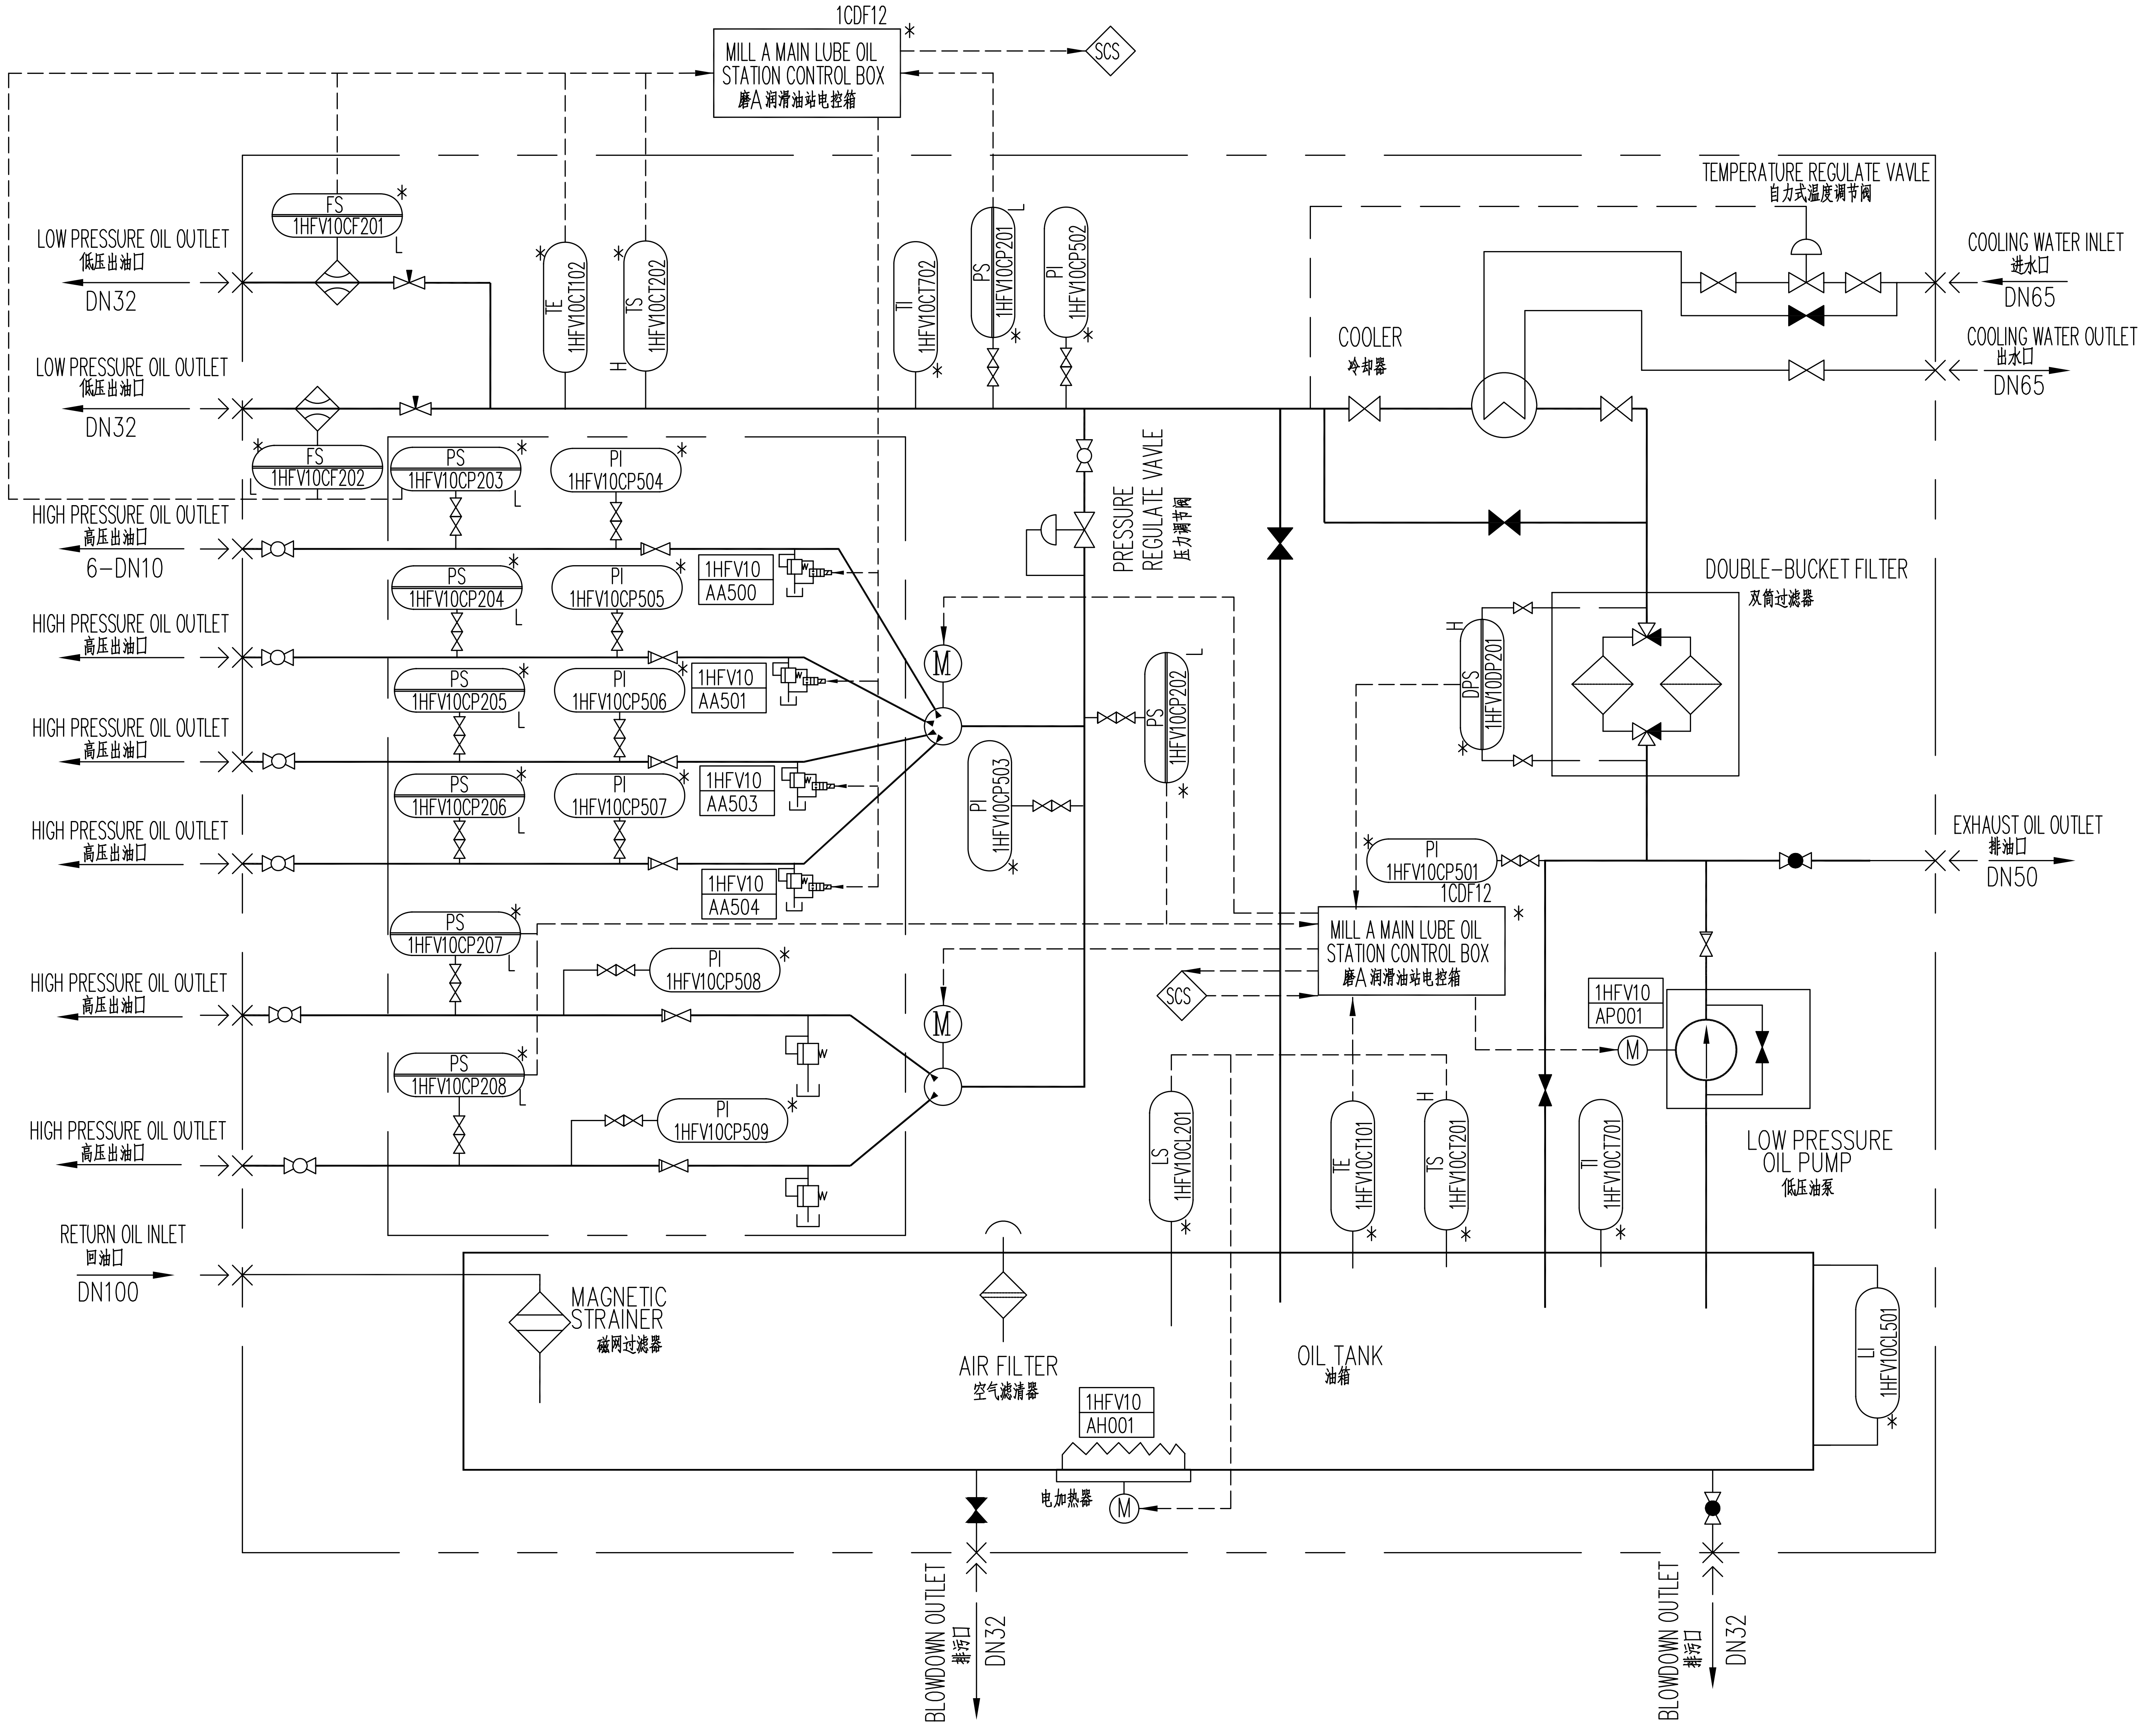

NOTE:

1. THE NUMBER OF THE VALVE FOR TRANSMITTERS AND INDICATORS SHOWED IN THIS DRAWING IS ONLY FOR REFERRENCE, PLEASE SEE THE CORRESPONDING PIPE AND VALVE SHEET OR VOLUMES OF I&C FOR DETAIL.
2. SMART TRANSMITTERS EQUIPPED WITH LOCAL INDICATORS SHALL BE SUPPLIED FOR ALL TRANSMITTERS.
3、REFERENCE DRAWING NO.:NANTONG SOUTH LUBE HYDRAULIC PRESSURE EQUIPMENT LTC.CO.NRB061215
«GDR-60/10/170HIGH/LOW PRESSURE OIL STATION».
«MILL BODY LUBE OIL STATION MEASURE POINTS CONFIGURATION LIST».
4、ALL INSTRUMENTS IN THIS SYSTEM WILL BE SUPPLIED WITH OIL STATION EQUIPMENT.

说明：1. 图中仪表阀的数量仅为示意，详细配置参见仪表阀门清册。
2.所有变送器均为带就地指示的智能变送器。
3、参考图号：南通市南方润滑液压设备有限公司 NRB061215《GDR-60/10/170高低压稀油站》
《磨煤机润滑油站一次元件及测点位置清单》
4. 本系统包括仪表和所有设备均随油站供货。

竣工图
AS BUILT
西北电力设计院
Northwest Electric Power Design Institute

DOCUMENT STATUS	AS BUILT

REV.	DATE	DRAWN	DESIGNED	CHECKED	REVIEWED		APPROVED	DESCRIPTION
0	2010.08		纪如龙	王晨	徐永成		于淑文	

OWNER	QUANG NINH THERMAL POWER JOINT STOCK COMPANY		
CONTRACTOR	SHANGHAI ELECTRIC (GROUP) CORPORATION		
SUBCONTRACTOR	NORTHWEST ELECTRIC POWER DESIGN INSTITUTE		
CONTRACT NO.	32003/QNTPJSC-SEC	PROJECT CONTROL NO.	QN1-SEC-I-52-HFV-0103-19

Nwepdi
西北电力设计院

COPYRIGHT (C)
USED FOR THE PROJECT ONLY.
NWEPDI RESERVE THE RIGHT OF
RECOURSE AGAINST INFRINGEMENT.

QUANG NINH THERMAL POWER PLANT PHASE 1: 2X300MW PROJECT | DETAIL | DESIGN STAGE

P&ID FOR MILL A MAIN BEARING OIL STATOIN
磨煤机A主轴承稀油站仪表控制系统图

UNITS	mm	SCALE	1:1	DAWG. NO.	F4091S-K0103-19	SHEET 1 OF 1	REV.	

ENGIN. DESIGN CERTIFICATE GRADE A No. 260001-sj