ENGIN. DESIGN CERTIFICATE GRADE A No. 260001-sj

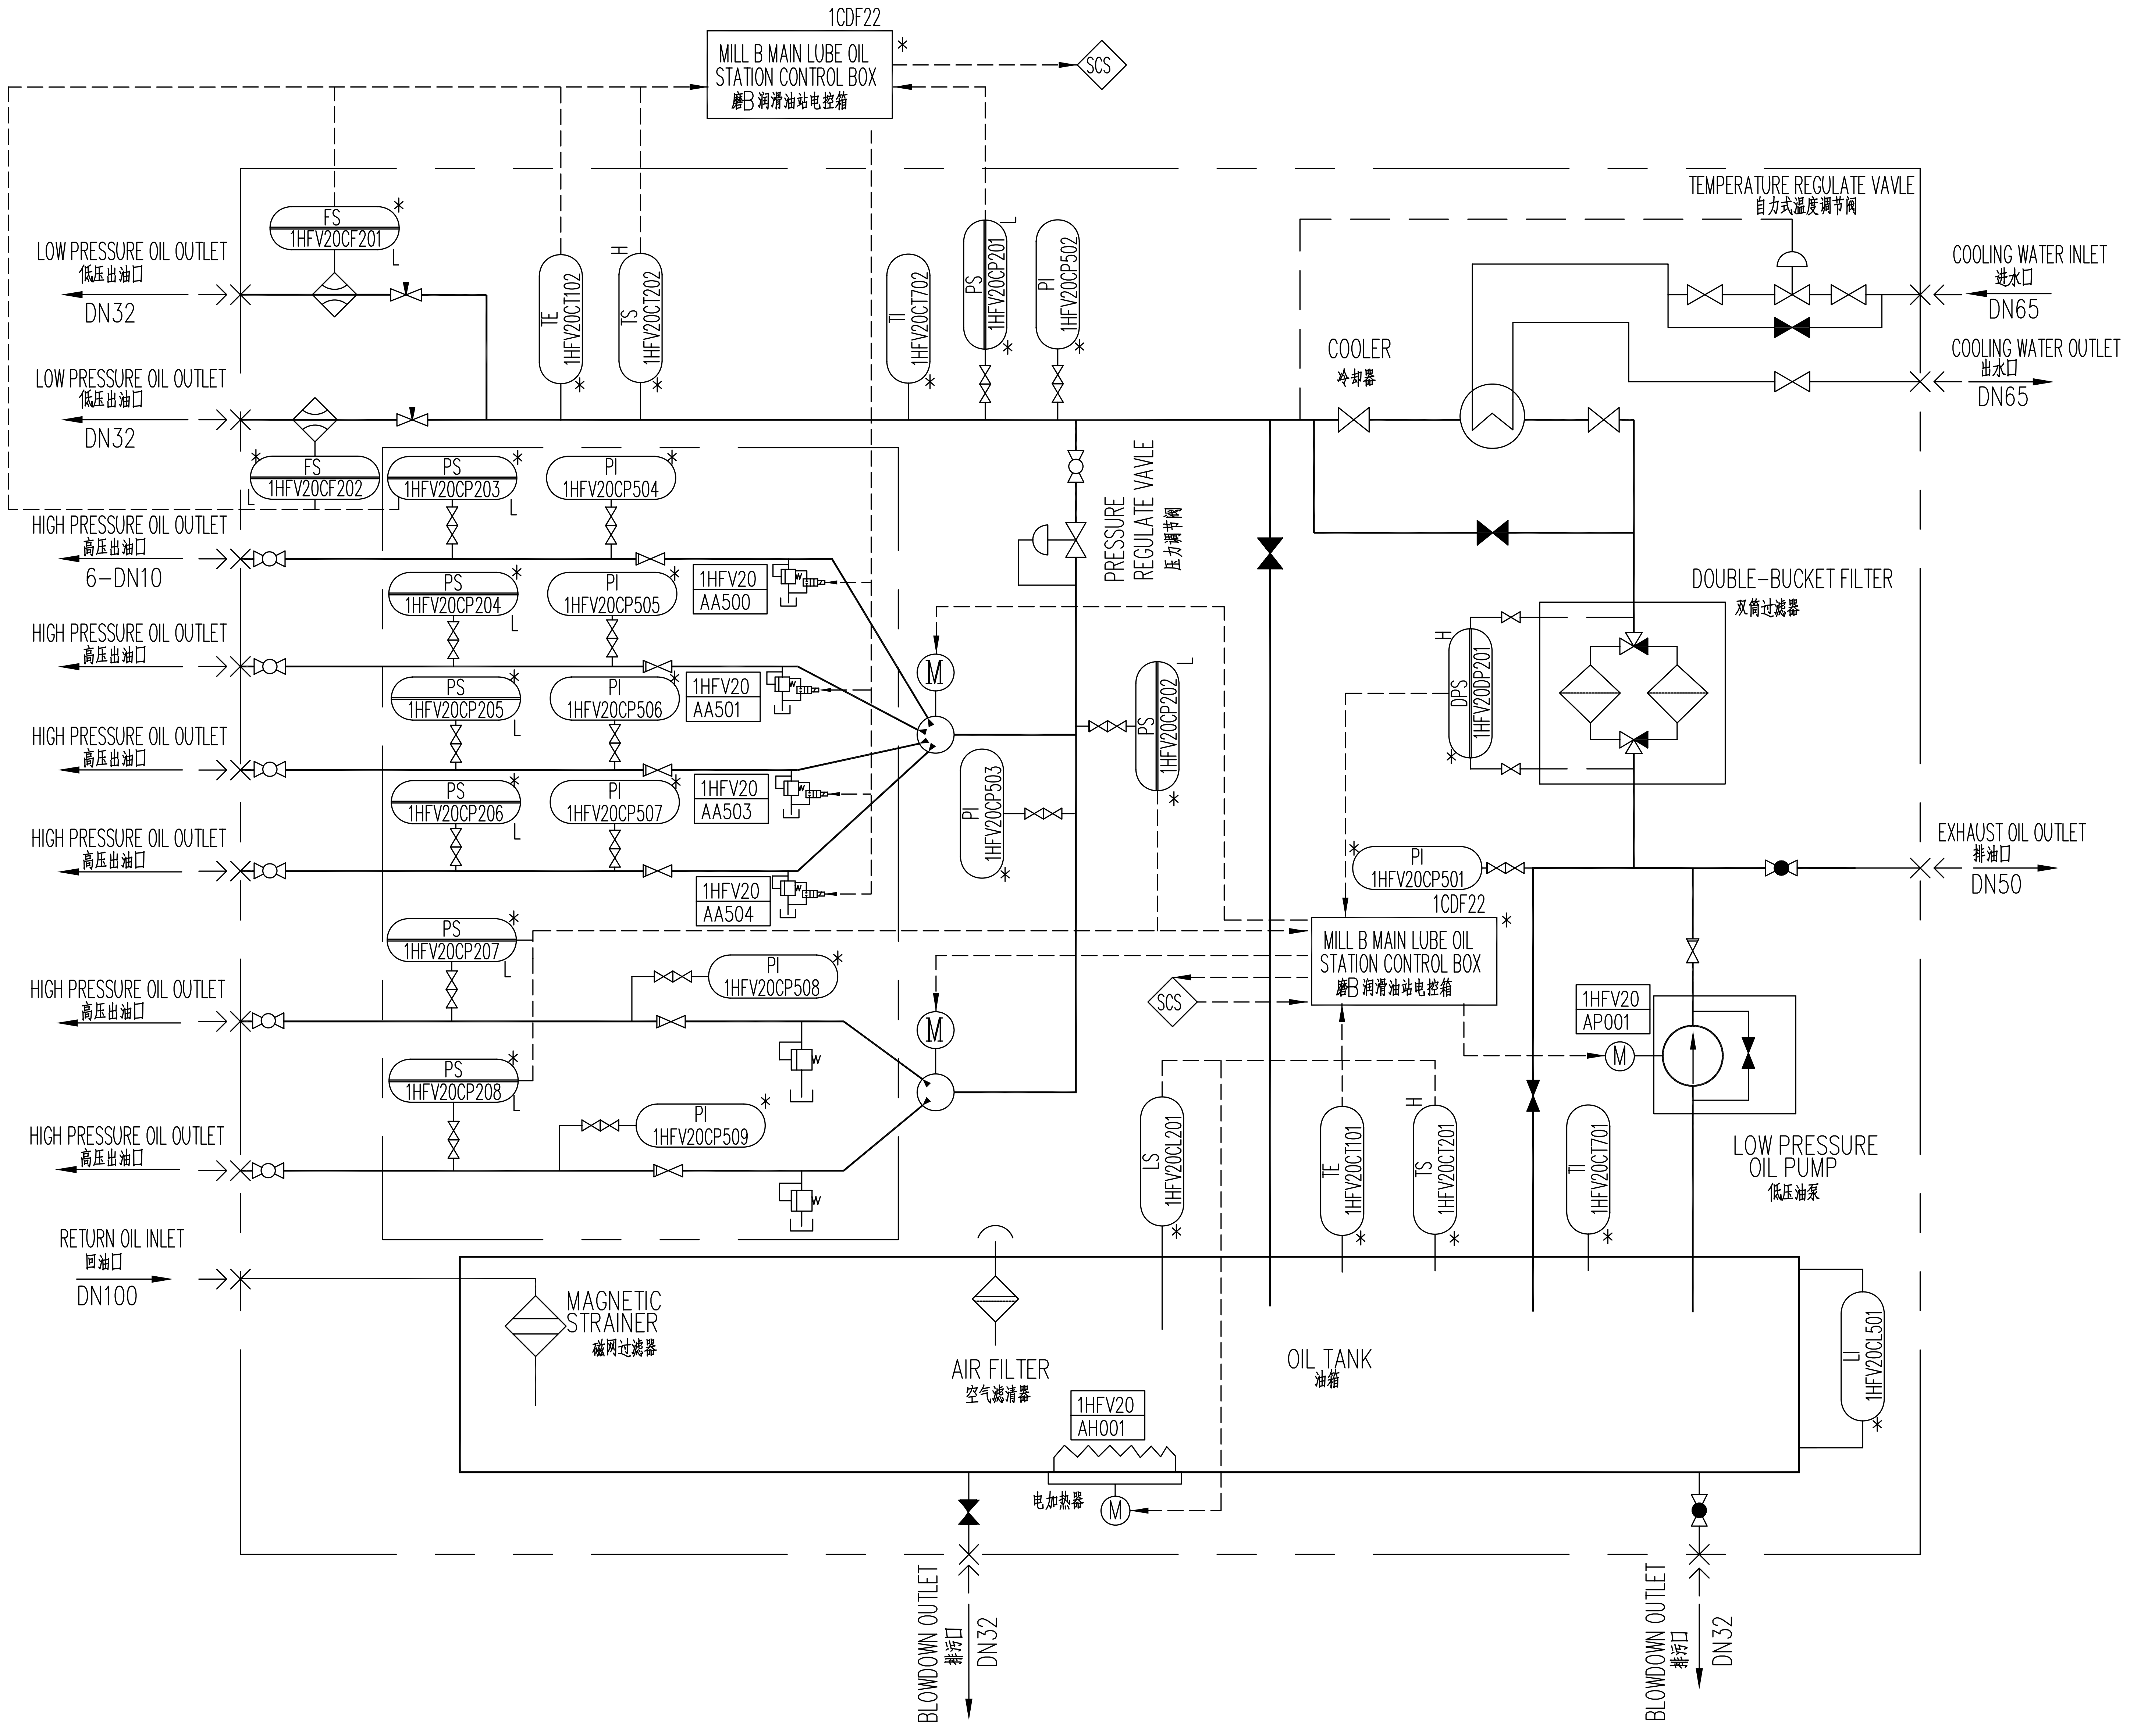

NOTE:

1. THE NUMBER OF THE VALVE FOR TRANSMITTERS AND INDICATORS SHOWED IN THIS DRAWING IS ONLY FOR REFERRENCE, PLEASE SEE THE CORRESPONDING PIPE AND VALVE SHEET OR VOLUMES OF I&C FOR DETAIL.
2. SMART TRANSMITTERS EQUIPPED WITH LOCAL INDICATORS SHALL BE SUPPLIED FOR ALL TRANSMITTERS.
3、REFERENCE DRAWING NO.:NANTONG SOUTH LUBE HYDRAULIC PRESSURE EQUIPMENT LTC.CO.NRB061215
«GDR-60/10/170HIGH/LOW PRESSURE OIL STATION».
«MILL BODY LUBE OIL STATION MEASURE POINTS CONFIGURATION LIST».
4、ALL INSTRUMENTS IN THIS SYSTEM WILL BE SUPPLIED WITH OIL STATION EQUIPMENT.

说明：1. 图中仪表阀的数量仅为示意，详细配置参见仪表阀门清册。
2.所有变送器均为带就地指示的智能变送器。
3、参考图号：南通市南方润滑液压设备有限公司 NRB061215《GDR-60/10/170高低压稀油站》
《磨煤机润滑油站一次元件及测点位置清单》
4. 本系统包括仪表和所有设备均随油站供货。

竣工图
AS BUILT
西北电力设计院
Northwest Electric Power Design Institute

DOCUMENT STATUS	AS BUILT

0	2010.08				徐永成			
REV.	DATE	DRAWN	DESIGNED	CHECKED	REVIEWED		APPROVED	DESCRIPTION

OWNER	QUANG NINH THERMAL POWER JOINT STOCK COMPANY		
CONTRACTOR	SHANGHAI ELECTRIC (GROUP) CORPORATION		
SUBCONTRACTOR	NORTHWEST ELECTRIC POWER DESIGN INSTITUTE		
CONTRACT NO.	32003/QNTPJSC-SEC	PROJECT CONTROL NO.	QN1-SEC-I-52-HFV-0103-20

Nwepdi
西北电力设计院

COPYRIGHT (C)
USED FOR THE PROJECT ONLY.
NWEPDI RESERVE THE RIGHT OF
RECOURSE AGAINST INFRINGEMENT.

QUANG NINH THERMAL POWER PLANT PHASE 1: 2X300MW PROJECT | DETAIL | DESIGN STAGE

P&ID FOR MILL B MAIN BEARING OIL STATOIN
磨煤机B主轴承稀油站仪表控制系统图

UNITS	mm	SCALE	1:1	DAWG. NO.	F4091S-K0103-20	SHEET 1 OF 1	REV.	